


1 FDAS AND FEX LOCATION PLAN
EE-01

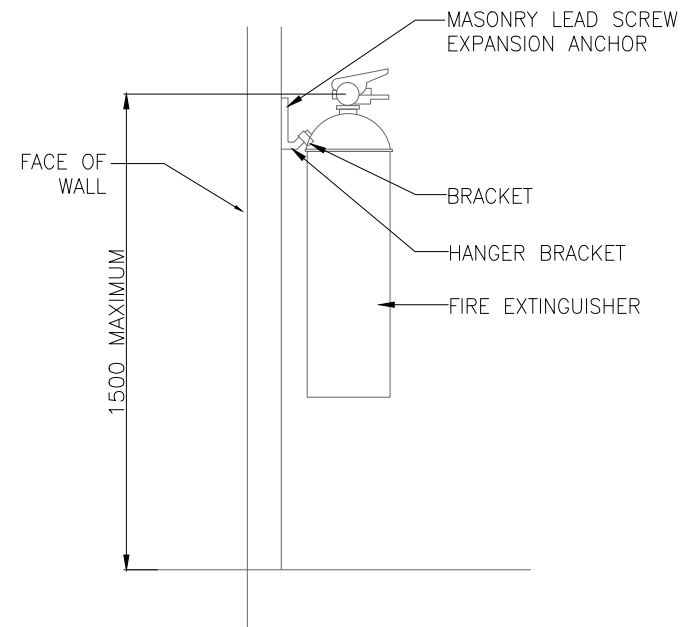

2 FIRE EXTINGUISHER INSTALLATION PLAN
EE-01

LEGEND:

| SYMBOL | QTY | DESCRIPTION |
|--------|---------|--|
| | 1 UNITS | MULTI-PURPOSE DRY CHEMICAL W/ 2A MIN. RATING (RED) |
| | 1 UNITS | CLEAN EXTINGUISHER AGENT (GREEN) |
| | 7 UNITS | SMOKE DETECTOR |
| | 1 UNITS | ALARM BELL 6" DIAMETER |
| | 1 UNITS | MANUAL PULL STATION |
| | 1 UNIT | FIRE ALARM CONTROL SYSTEM |

| | | | |
|---|---|--------------------------------------|-------------|
| | | | |
| CONFORME: | | CONFORME: | |
| _____ HEAD, Division (End User) | | _____ HEAD, Department (End User) | |
| DRAWN | SURVEYED | DESIGNED | CHECKED |
| Checked & Certified : | | | |
| ENGR. MARITES R. PANGILINAN Professional Electrical Engineer | | | |
| 11/F Alphaland Southgate Tower 2258 Chino Roces Ave corner EDSA Makati City 1232 Philippines T 63 2 479 5600 F 63 2 479 5601 E mnlmail@ghd.com W www.ghd.com | | | |
| Approved : | | | |
| _____ Project Manager | | | |
| ALTERNATIVE POWER SOLUTIONS, INC. 1424 LIBRADA AVENUE STREET PANDACAN MANILA TEL: (02) 420281 TEL/FAX: (02) 420281 | | | |
| AS-BUILT DRAWING | | | |
| PROJECT TITLE: CONSULTANCY SERVICES FOR THE ENGINEERING, PROCUREMENT AND CONSTRUCTION MANAGEMENT FOR THE LA MESA TREATMENT PLANT 2 PROCESS IMPROVEMENT WORKS | | | |
| LOCATION: MAYNILAD – AYALA SOUTHVALE | | | |
| SHEET CONTENT: FDAS AND FEX LOCATION PLAN FIRE EXTINGUISHER INSTALLATION PLAN | | | |
| SCALE: | CONTRACT NO. OP18REFCS03-ASV-EE01-FDAS | SHEET NO. 01 OF 01 | REV. 00 |
| REVISION | | | |
| REV | DATE | BY | APPROVED BY |
| | | | |
| | | | |
| | | | |