





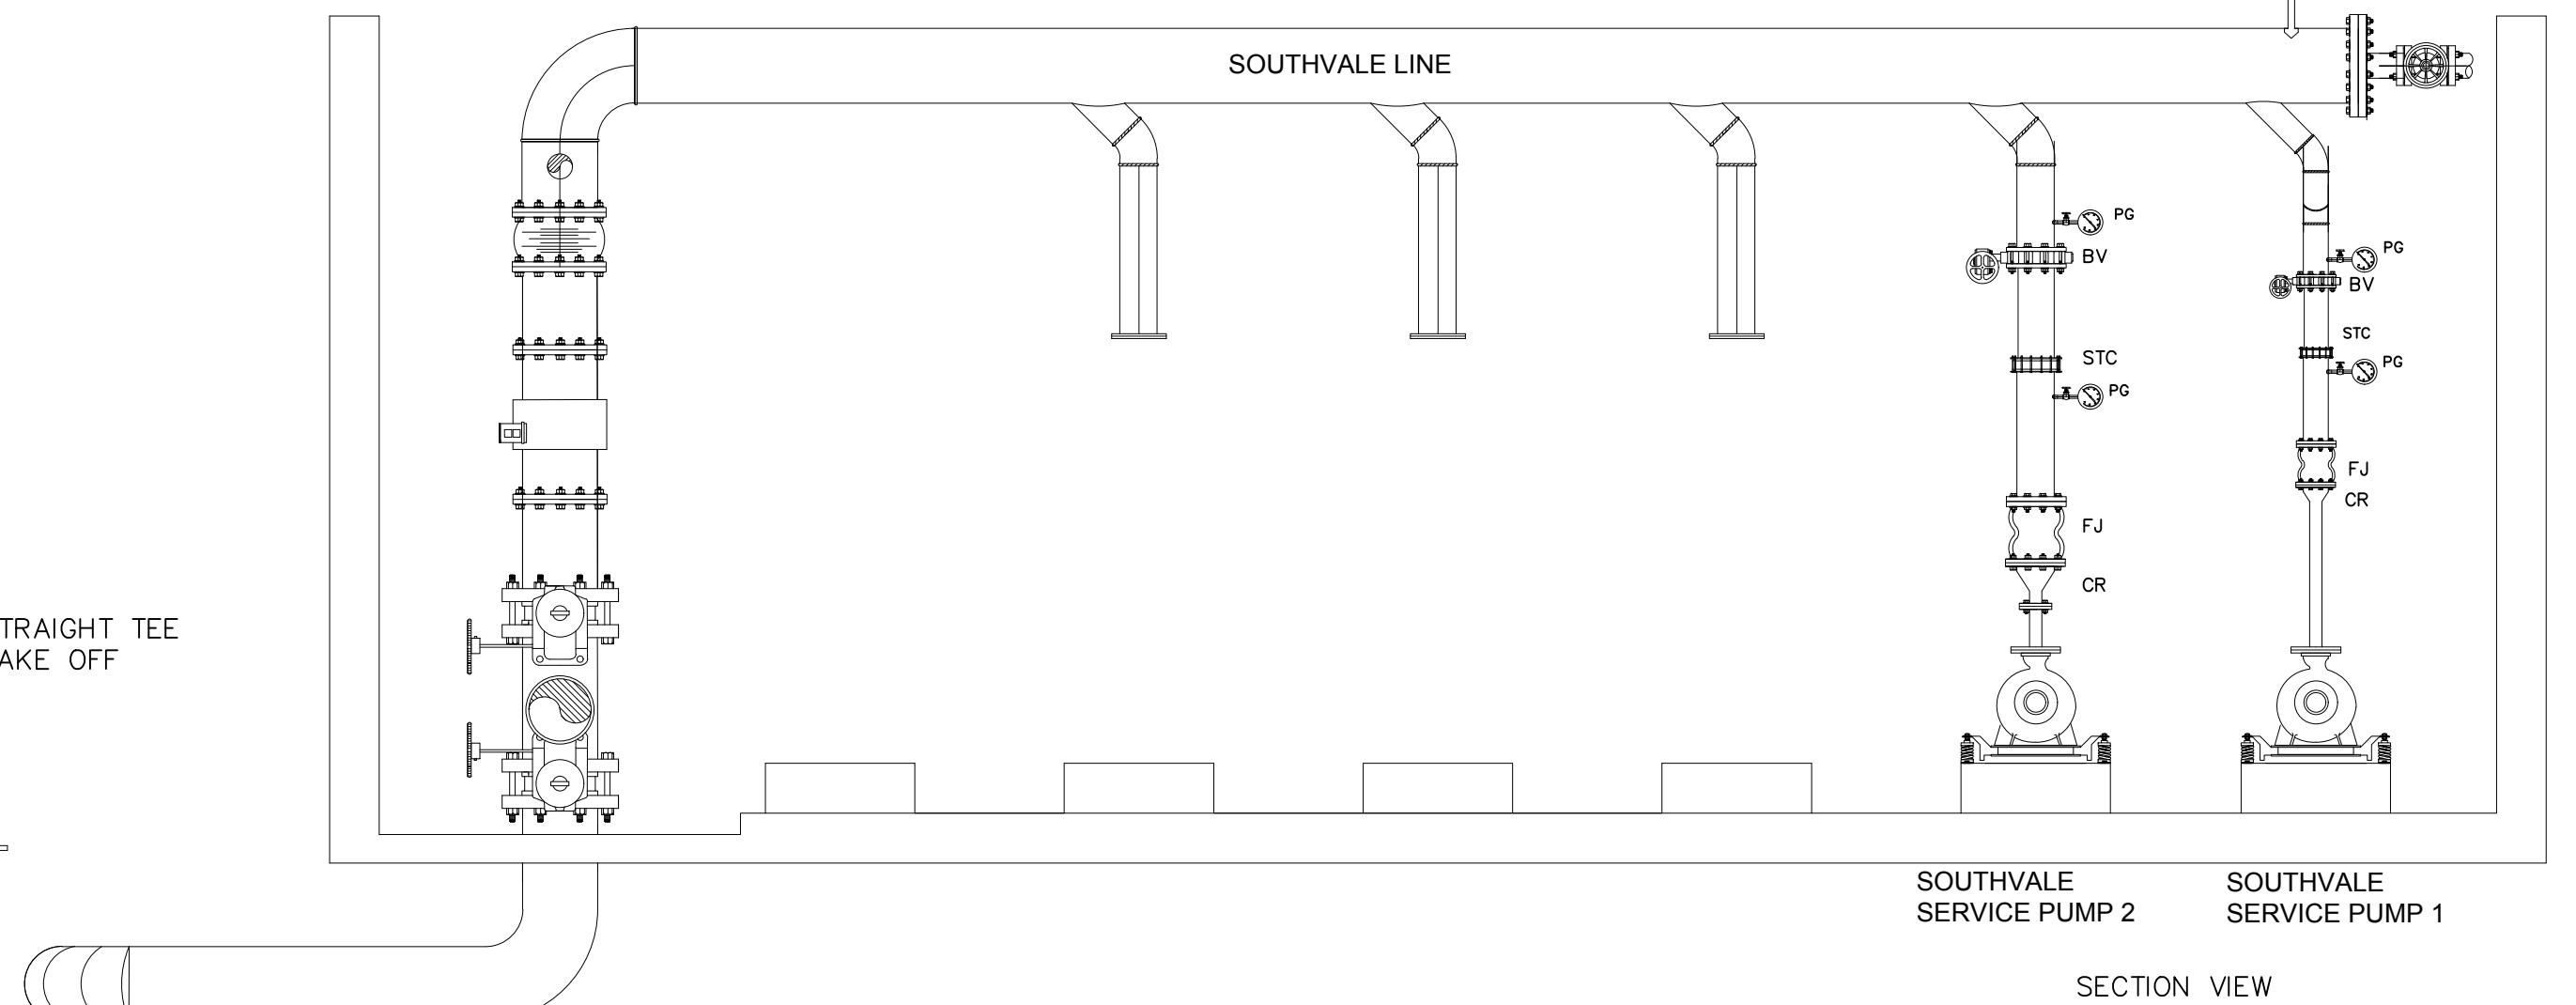

AS-FOUND NOTES:

1. PIPING AND FITTINGS
 - 1.1. THERE ARE CURRENTLY TWO SEPARATE DISCHARGE LINES: TO SOUTHVALE AND TO SONERA; CORRESPONDING PIPING FOLLOWS
 - 1.2. LINE FROM RESERVOIR TO PUMP HOUSE NOT SHOWN
 - 1.3. SOME PIPING FOUND IN FRONT OF PUMP HOUSE NOT SHOWN IN OLD AS BUILT
2. INSTALLATION
 - 2.1. NO CBP INSTALLED INSIDE PUMP HOUSE; NO CORRESPONDING PIPING, FITTINGS AND FOUNDATION BLOCK
 - 2.2. SOUTHVALE BOOSTER PUMP 1 IS INSTALLED IN PLACE OF JOCKEY PUMP
 - 2.2. SOUTHVALE SERVICE PUMPS (10HP) ARE INDIRECT DRIVEN WHILE SONERA SERVICE PUMPS (15HP) ARE DIRECT DRIVEN
3. PIPE SUPPORT
 - 3.1. STEEL SADDLE SUPPORT USED INSTEAD OF PIPE HANGER
 - 3.2. SPACING OF SUPPORT OUTLINE FOLLOWED
4. PUMP HOUSE
 - 4.1. ROLL UP DOOR PROVIDED
 - 4.2. NO CI TANKS AND DUCTING AS CHLORINATION ROOM WAS CONVERTED INTO OPERATOR'S ROOM
 - 4.3. CHLORINE GAS TANKS LOCATED OUTSIDE BESIDE PUMP HOUSE

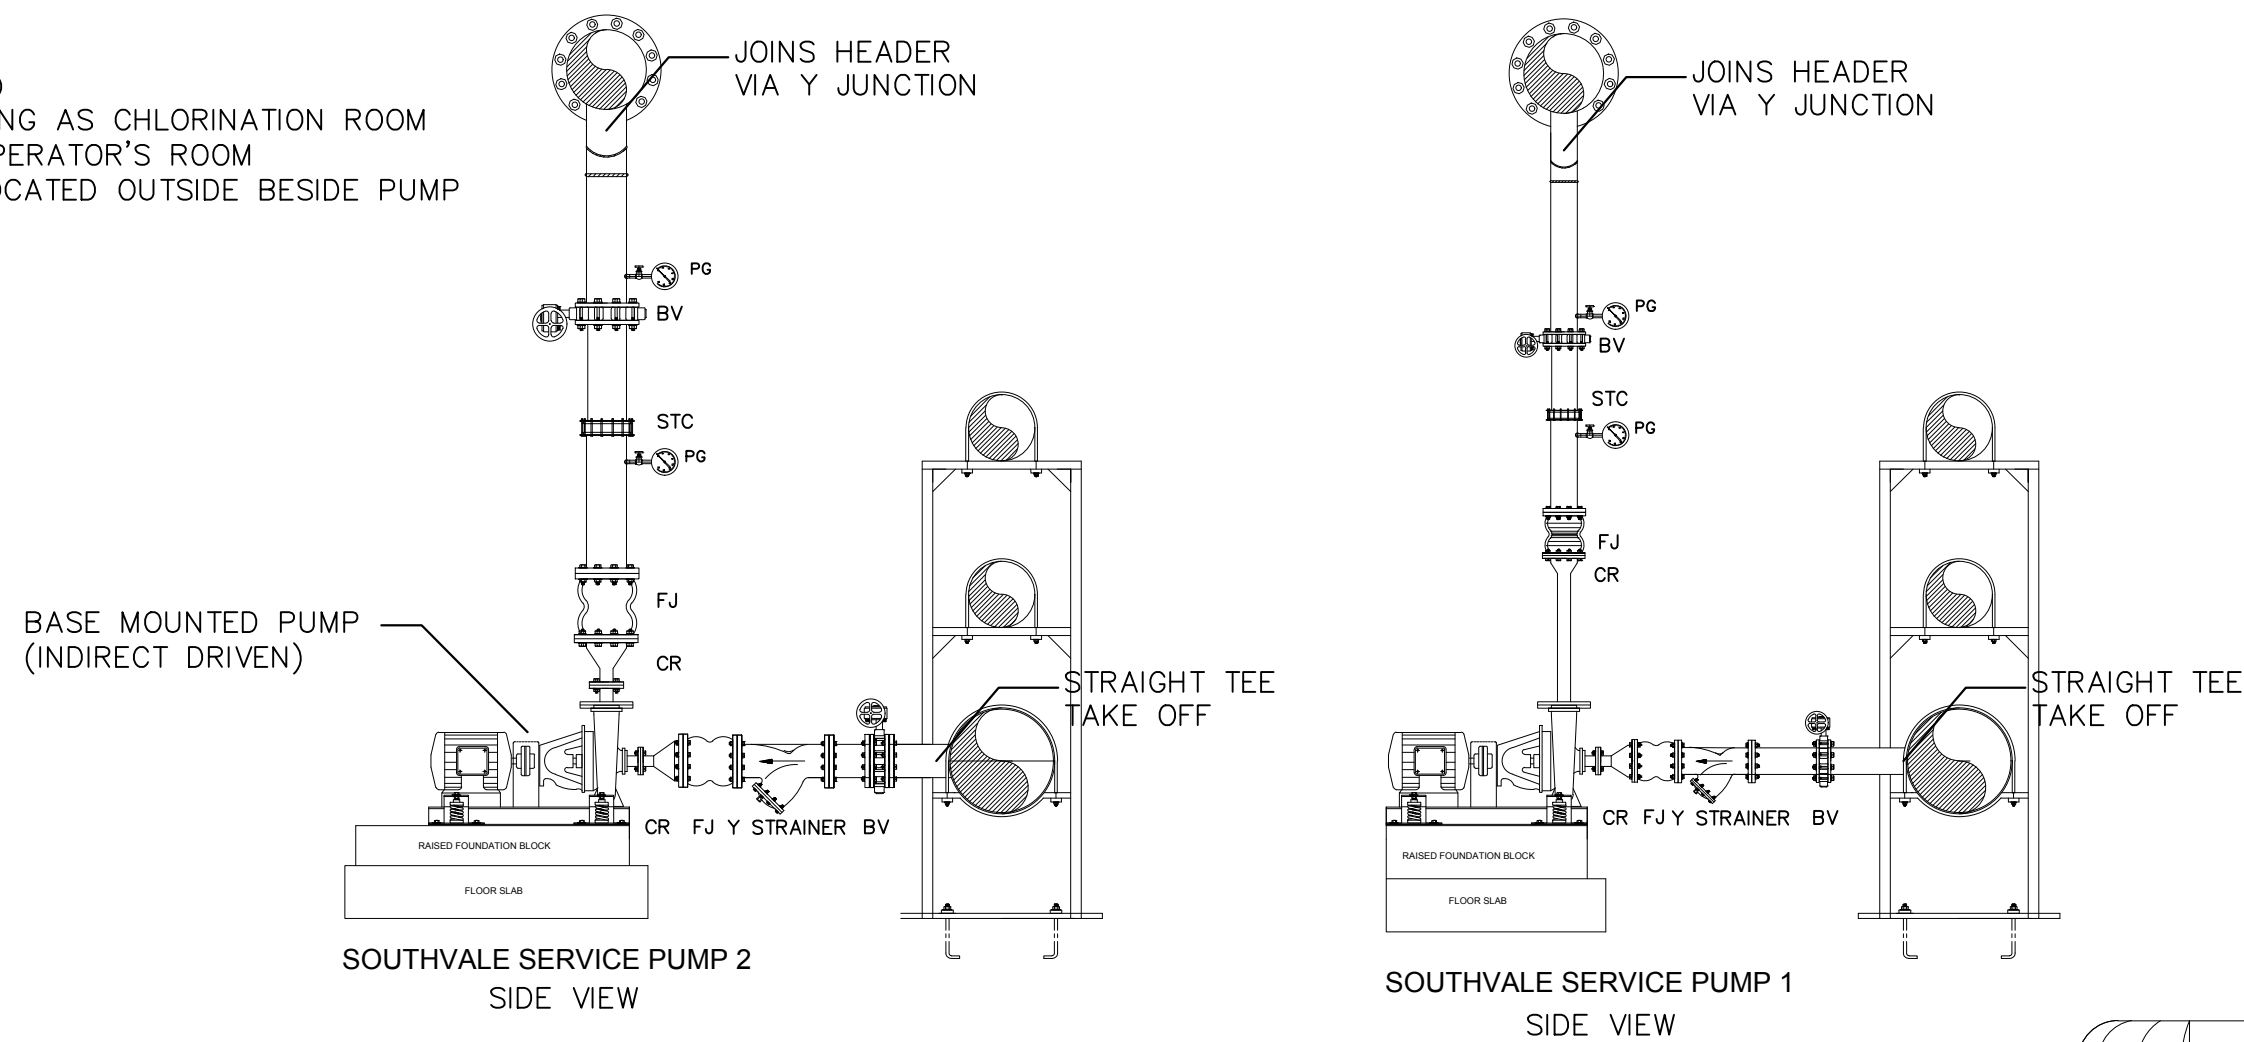

A
ME
AS-FOUND
SCALE
NTS

<div> Maynilad</div> <div>CONFORME:</div> <div>_____ HEAD, Division (End User)</div>				<div><div> Maynilad</div><div>CONFORME:</div><div>_____ HEAD, Department (End User)</div></div>				<div><div><div>A</div><div>ME</div></div><div>AS-FOUND</div><div>SCALE NTS</div></div>											
DRAWN		SURVEYED		DESIGNED		CHECKED		Checked & Certified :											
DRAW		SURVEYED		DESIGNED		CHECKED		ROSENDO B. SANCHEZ, PME PROFESSIONAL MECHANICAL ENGINEER											
REVISION								PROFESSION : PME				PTR : 7341148				Approved : _____ NAM LE Project Manager			
REV		DATE		BY		APPROVED BY		REGISTRATION NO. : 3999				DATE ISSUED : 01-07-2019							
								TIN : 205-811-966				PLACE ISSUED : MAKATI_CITY							
<div> 11/F Alphaland Southgate Tower 2258 Chino Roces Ave corner EDSA Makati City 1232 Philippines T 63 2 479 5600 F 63 2 479 5601 E mnlnmail@ghd.com W www.ghd.com</div>				<div> RBSANCHEZ PME CONSULTANTS & ASSOCIATES, INC. Makati Corporate Office: 28th Floor Cityland Pasong Tama Tower U2807, 2210 Chino Roces Avenue, Makati City, Philippines. Telefax No. 776-5879 Cell No. +639 273 006 000 Website: www.rbs-engineers.com</div>				RBS DESIGN UNIT		ROSENDO B. SANCHEZ, PME HEAD, Engineering									
				RBS DESIGN SECTION															
CONTRACT DRAWING																			
PROJECT TITLE: CONSULTANCY SERVICES FOR THE PLANT AUDIT IN VARIOUS PUMP STATIONS AND RESERVOIRS																			
LOCATION: AYALA SOUTHVALE PUMP STATION AND RESERVOIR																			
SHEET CONTENT: AS-FOUND																			
SCALE: NTS				CONTRACT NO. OP18REFCS03-AYA-MECH-007				SHEET NO. 1 OF 1				REV. A							