



A FRONT ELEVATION PLAN
ME SCALE 1:100



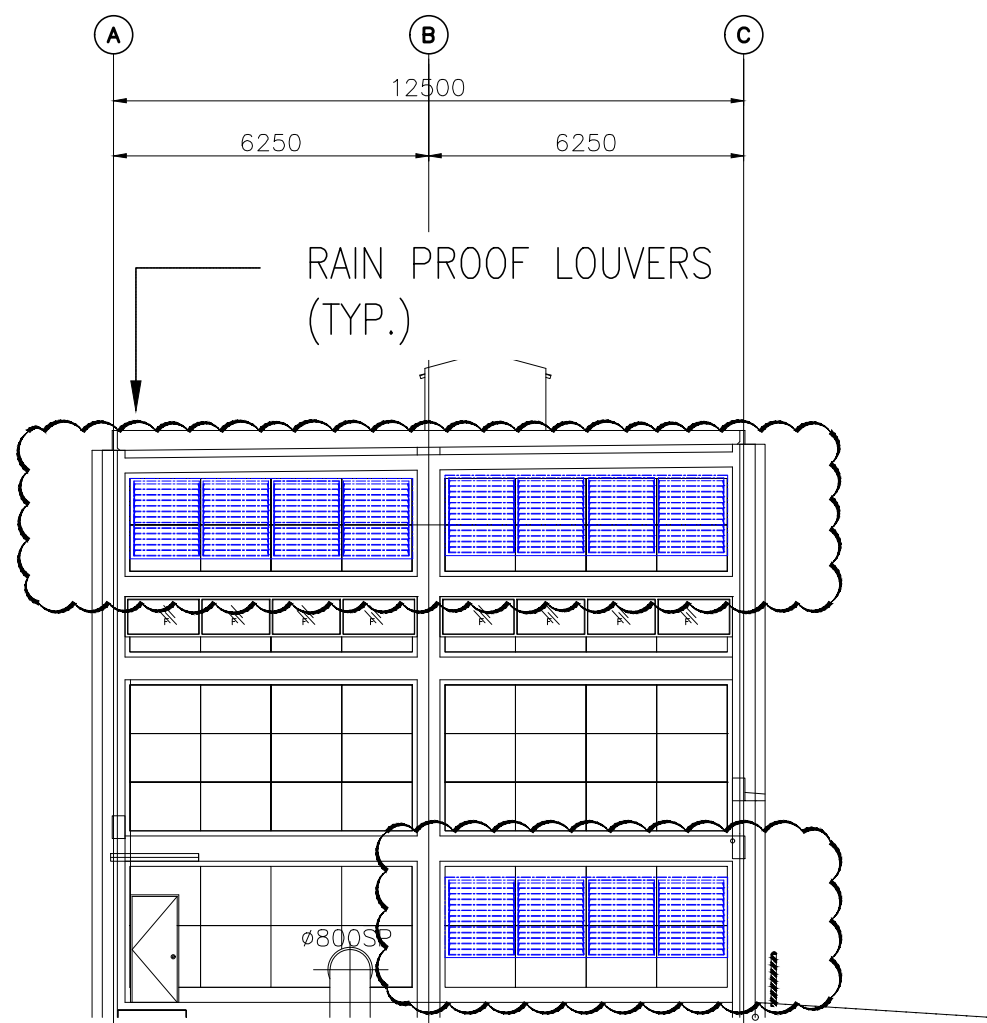

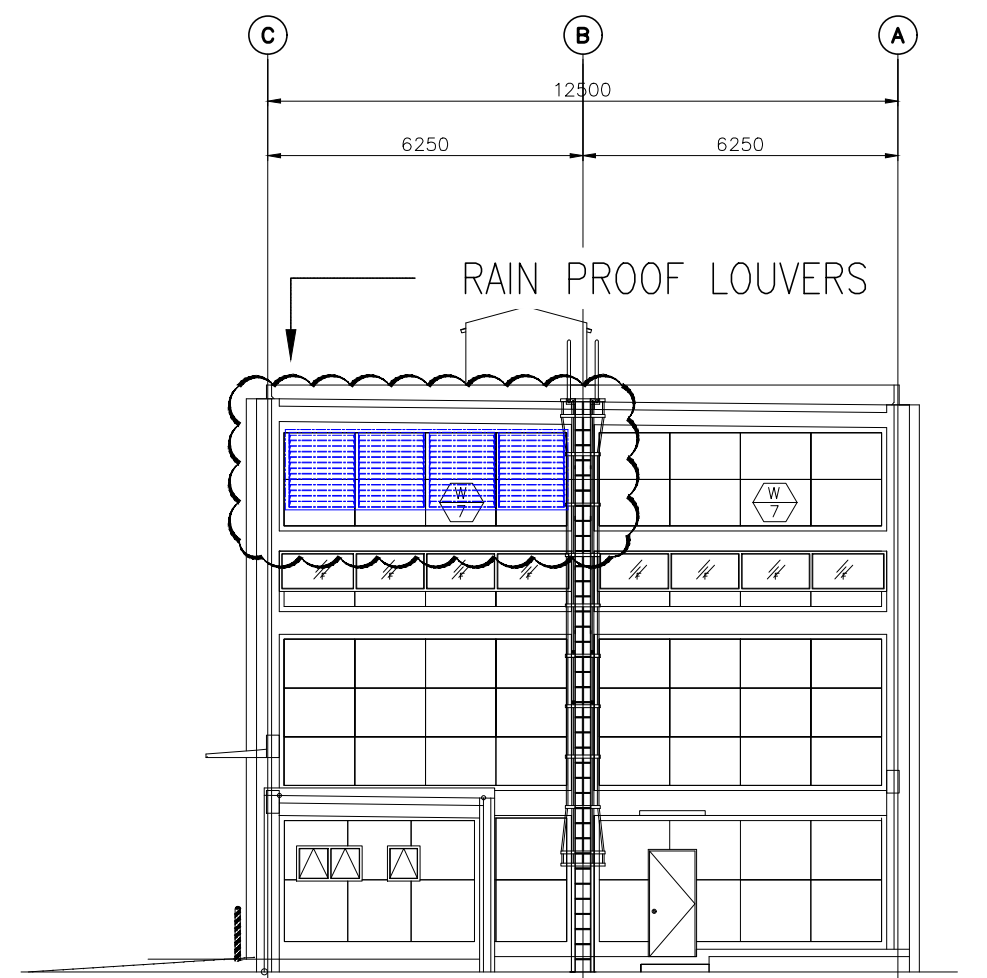

B LEFT ELEVATION PLAN
ME SCALE 1:150



C RIGHT ELEVATION PLAN
ME SCALE 1:150

1 NATURAL VENTILATION LAYOUT
ME SCALE 1:100

- NOTES:**
1. THIS DRAWING IS CREATED IN REFERENCE TO AS-BUILT MECHANICAL DRAWING NO. OP-09-PPS-01, PASAY_ME-03.
 2. REVISION CLOUD AND HIGHLIGHT INFORMATION WERE VERIFIED ON SITE THRU SITE VISUAL INSPECTION. OTHER INFORMATION WERE DIRECT COPY FROM THE AS-BUILT DRAWINGS PROVIDED BY MAYNILAD.

<div> Maynilad</div> <div>CONFORME:</div> <div>_____ HEAD, Division (End User)</div>				<div><div> Maynilad</div><div>CONFORME:</div><div>_____ HEAD, Department (End User)</div></div>				<div><div><div>1</div><div>ME</div></div><div>NATURAL VENTILATION LAYOUT</div><div>SCALE1:100</div></div>												<div>NOTES:<div><div>1.</div><div>THIS DRAWING IS CREATED IN REFERENCE TO AS-BUILT MECHANICAL DRAWING NO. OP-09-PPS-01, PASAY_ME-03.</div></div><div><div>2.</div><div>REVISION CLOUD AND HIGHLIGHT INFORMATION WERE VERIFIED ON SITE THRU SITE VISUAL INSPECTION. OTHER INFORMATION WERE DIRECT COPY FROM THE AS-BUILT DRAWINGS PROVIDED BY MAYNILAD.</div></div></div>											
DRAWN		SURVEYED		DESIGNED		CHECKED		Checked & Certified : <div>ROSENDO B. SANCHEZ, PME PROFESSIONAL MECHANICAL ENGINEER</div>										<div><div></div><div>11/F Alphaland Southgate Tower 2258 Chino Roces Ave corner EDSA Makati City 1232 Philippines T 63 2 479 5600 F 63 2 479 5601 E mnlmail@ghd.com W www.ghd.com</div></div>				<div><div></div><div>RBSANCHEZ PME CONSULTANTS & ASSOCIATES, INC. Makati Corporate Office: 28th Floor Cityland Pasong Tamo Tower U2807, 2210 Chino Roces Avenue, Makati City, Philippines. Telefax No. 776-5879 Cell No. +639 273 006 000 Website: www.rbs-engineers.com</div></div>				<div>CONTRACT DRAWING</div>					
DRAW		SURVEYED		DESIGNED		CHECKED		REVISION										PROJECT TITLE: CONSULTANCY SERVICES FOR THE PLANT AUDIT IN VARIOUS PUMP STATIONS AND RESERVOIRS													
REV	DATE	BY	APPROVED BY					PROFESSION : PME				PTR : 7341148				APPROVED :				RBS DESIGN UNIT		ROSENDO B. SANCHEZ, PME HEAD, Engineering				LOCATION: PAGCOR PUMP STATION AND RESERVOIR, PASAY CITY					
								REGISTRATION NO. : 3999				DATE ISSUED : 01-07-2019								RBS DESIGN SECTION						SHEET CONTENT: NATURAL VENTILATION LAYOUT					
								TIN : 205-811-966				PLACE ISSUED : MAKATI_CITY														SCALE: NTS				CONTRACT NO. OP18REFCS03-PAG-MECH-005	