





- NOTE:
1. MODIFIED CONFIGURATION OF FITTINGS ON BOTH SUCTION AND DISCHARGE OBSERVE
 2. ADDITIONAL SUPPORT AS REQUIRED BY MODIFICATION
 3. OLD MACHINE FOUNDATION STILL EXIST

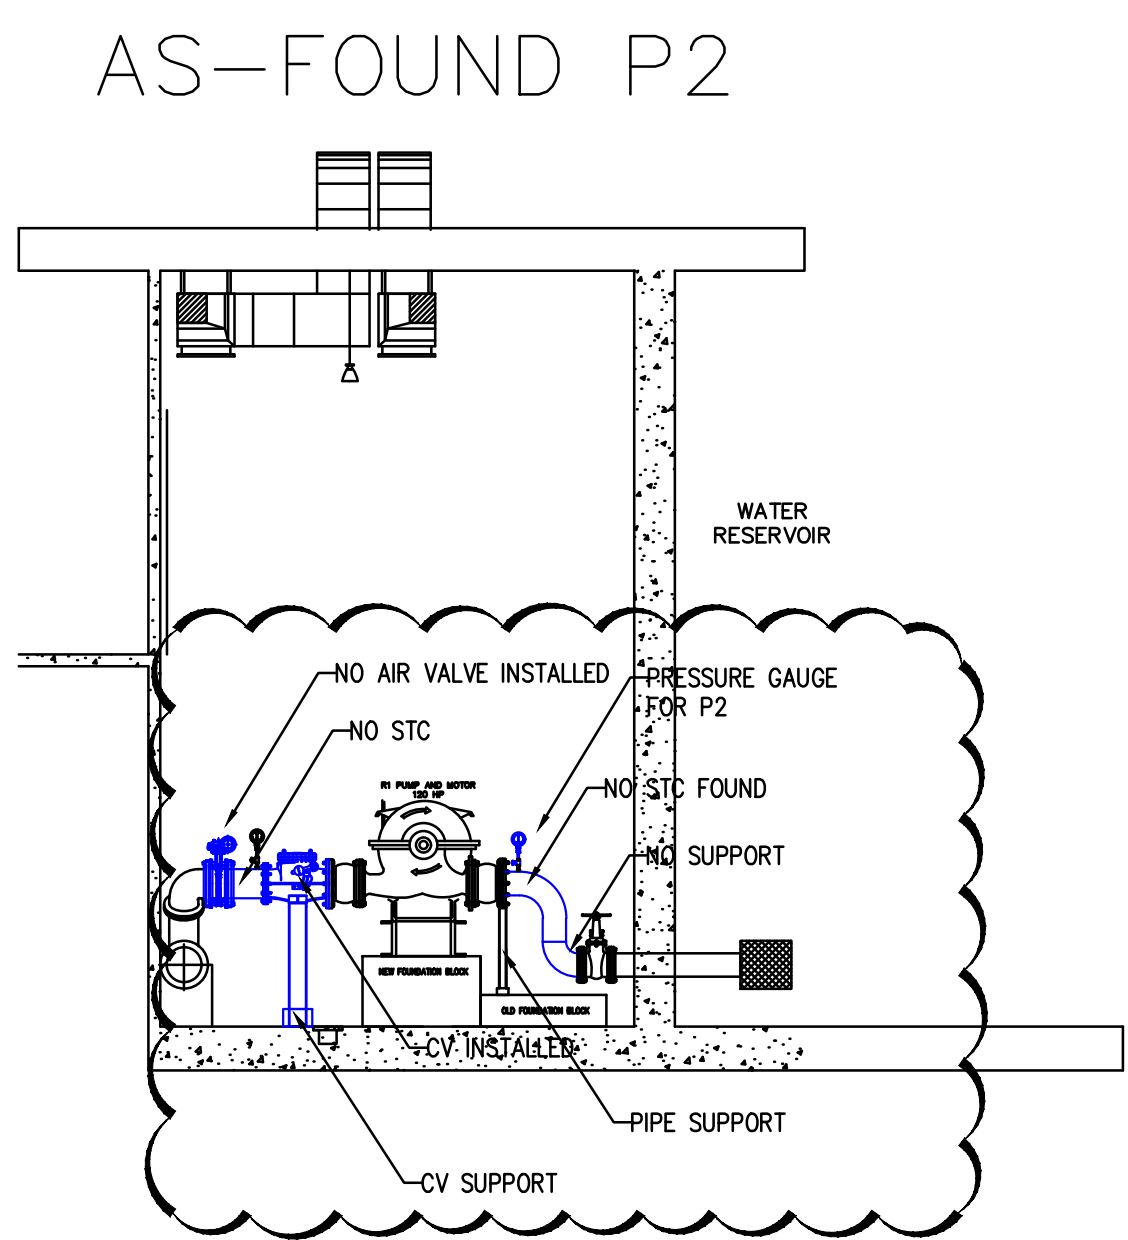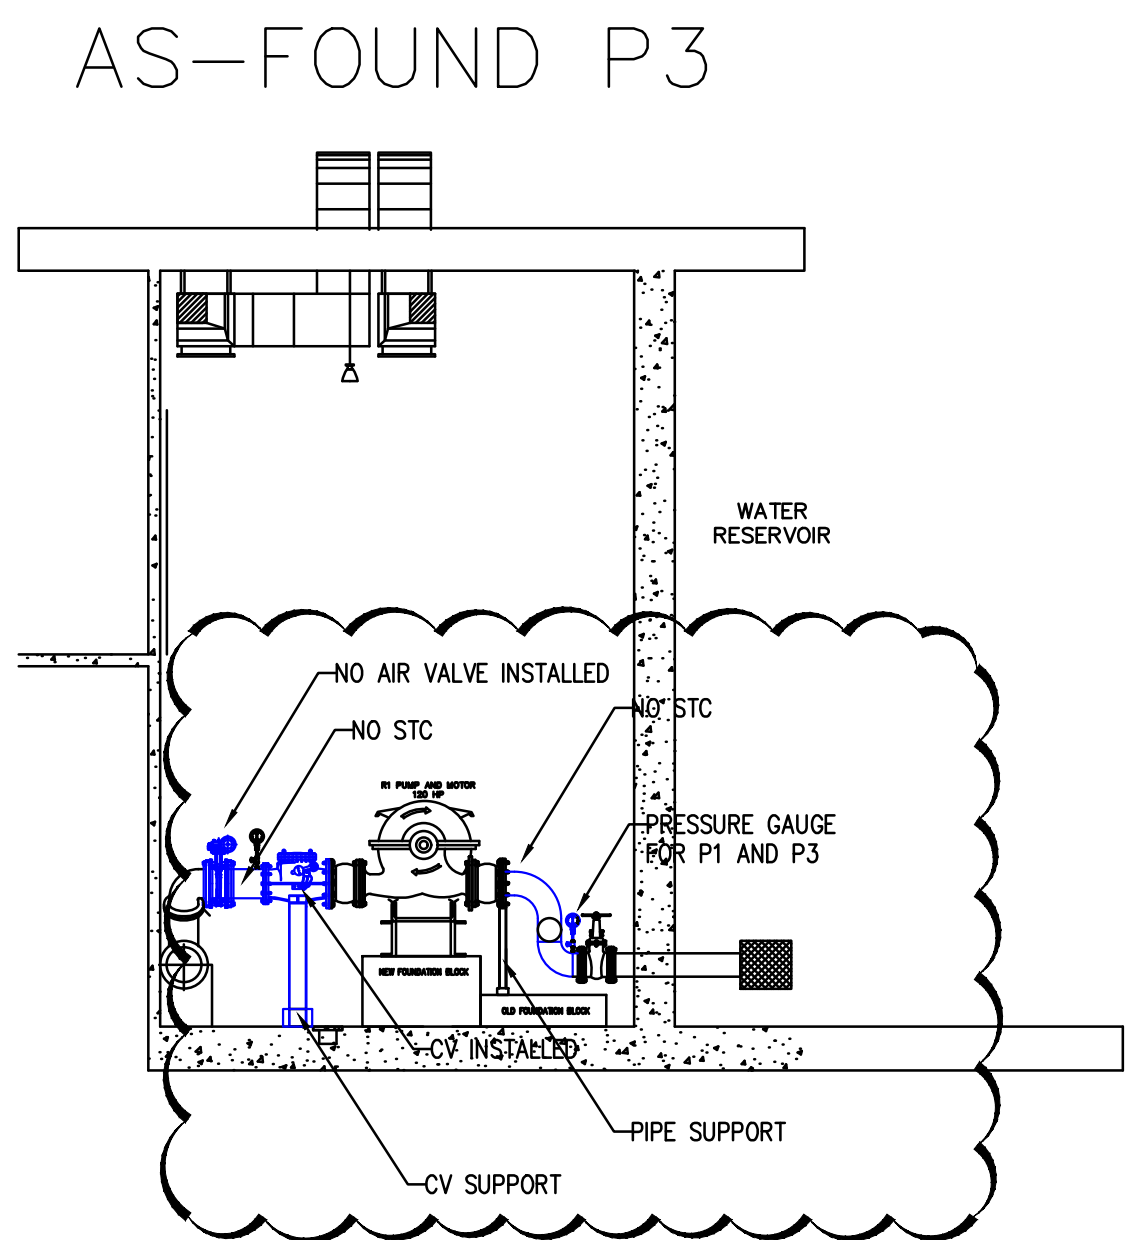

 CONFORME: _____ HEAD, Division (End User)				 CONFORME: _____ HEAD, Department (End User)			
DRAWN	SURVEYED	DESIGNED	CHECKED	DRAWN	SURVEYED	DESIGNED	CHECKED
REVISION							
REV	DATE	BY	APPROVED BY				

Checked & Certified : ROSENDO B. SANCHEZ, PME PROFESSIONAL MECHANICAL ENGINEER	
PROFESSION : PME	PTR : 7341148
REGISTRATION NO. : 3999	DATE ISSUED : 01-07-2019
TIN : 205-811-966	PLACE ISSUED : MAKATI_CITY

 11/F Alphaland Southgate Tower 2258 Chino Roces Ave corner
EDSA Makati City 1232 Philippines
T 63 2 479 5600 F 63 2 479 5601
E mnlmali@ghd.com W www.ghd.com

Approved :

NAM LE
Project Manager

 RBSANchez PME CONSULTANTS & ASSOCIATES, INC.
Makati Corporate Office: 28th Floor Cityland Pasong Tamo Tower U2807, 2210
Chino Roces Avenue, Makati City, Philippines
Telefax No. 776-5879 Cell No. +639 273 006 000
Website: www.rbs-engineers.com

RBS
DESIGN UNIT

ROSENDO B. SANCHEZ, PME
HEAD, Engineering

CONTRACT DRAWING			
PROJECT TITLE: CONSULTANCY SERVICES FOR THE PLANT AUDIT IN VARIOUS PUMP STATIONS AND RESERVOIRS			
LOCATION: AYALA ALABANG R1 PUMP STATION AND RESERVOIR			
SHEET CONTENT: AS-BUILT CHANGES			
SCALE: NTS	CONTRACT NO. OP18REFCS03-AAL-MECH-001	SHEET NO. 1 OF 1	REV. A