


LEGEND:

SYMBOL	QTY	DESCRIPTION
	5 UNITS	MULTI-PURPOSE DRY CHEMICAL W/ 2A MIN. RATING (RED)
	3 UNITS	CLEAN EXTINGUISHER AGENT
	20 UNITS	SMOKE DETECTOR BATTERY
	4 UNITS	ALARM BELL 6" DIAMETER, 220V
	4 UNITS	MANUAL PULL STATION
	7 UNITS	EMERGENCY LIGHT
	1 UNIT	FIRE ALARM CONTROL SYSTEM
	3 UNIT	FIRE ALARM ANNUNCIATOR PANEL

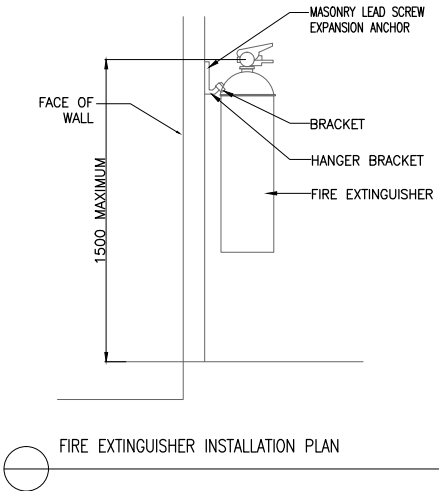

FIRE EXTINGUISHER INSTALLATION PLAN

CONFORME:

HEAD, Division (End User)

CONFORME:

HEAD, Department (End User)

DRAWN	SURVEYED	DESIGNED	CHECKED
REVISION			
REV	DATE	BY	APPROVED BY

1
EE-01

(FDAS, FEX, AND EL LOCATION PLAN)

Checked & Certified :
ENGR. MARITES R. PANGILINAN
Professional Electrical Engineer

11/F Alphaland Southgate Tower 2258 Chino Roces Ave corner
EDSA Makati City 1232 Philippines
T 63 2 479 5600 F 63 2 479 5601
E mnmail@ghd.com W www.ghd.com

Approved :

Project Manager

ALTERNATIVE POWER SOLUTIONS, INC.
1424 LUBRAHA AVENUE STREET PANDACAN MANILA
TEL: (02) 124231

DESIGN UNIT
ENGR. MARITES R. PANGILINAN
VP-OPERATIONS

DESIGN SECTION

AS-BUILT DRAWING

PROJECT TITLE: CONSULTANCY SERVICES FOR THE ENGINEERING, PROCUREMENT AND CONSTRUCTION MANAGEMENT FOR THE LA MESA TREATMENT PLANT 2 PROCESS IMPROVEMENT WORKS

LOCATION: MAYNILAD, AYALA ALABANG R1

SHEET CONTENT: FDAS, FEX, AND EL LOCATION PLAN

SCALE: CONTRACT NO. OP18REFCS03-RIP-EE01-FDAS SHEET NO. 01 OF 01 REV. 00