

LEGEND:

- G

—GENERATOR SET
- M

—MOTOR
- PM


—POWER METER
- AHF

—ADVANCED HARMONIC FILTER
- MTS

—MANUAL TRANSFER SWITCH
- VFD

—VARIABLE FREQUENCY DRIVE
- TVSS

—TRANSIENT VOLTAGE SURGE SUPPRESSOR

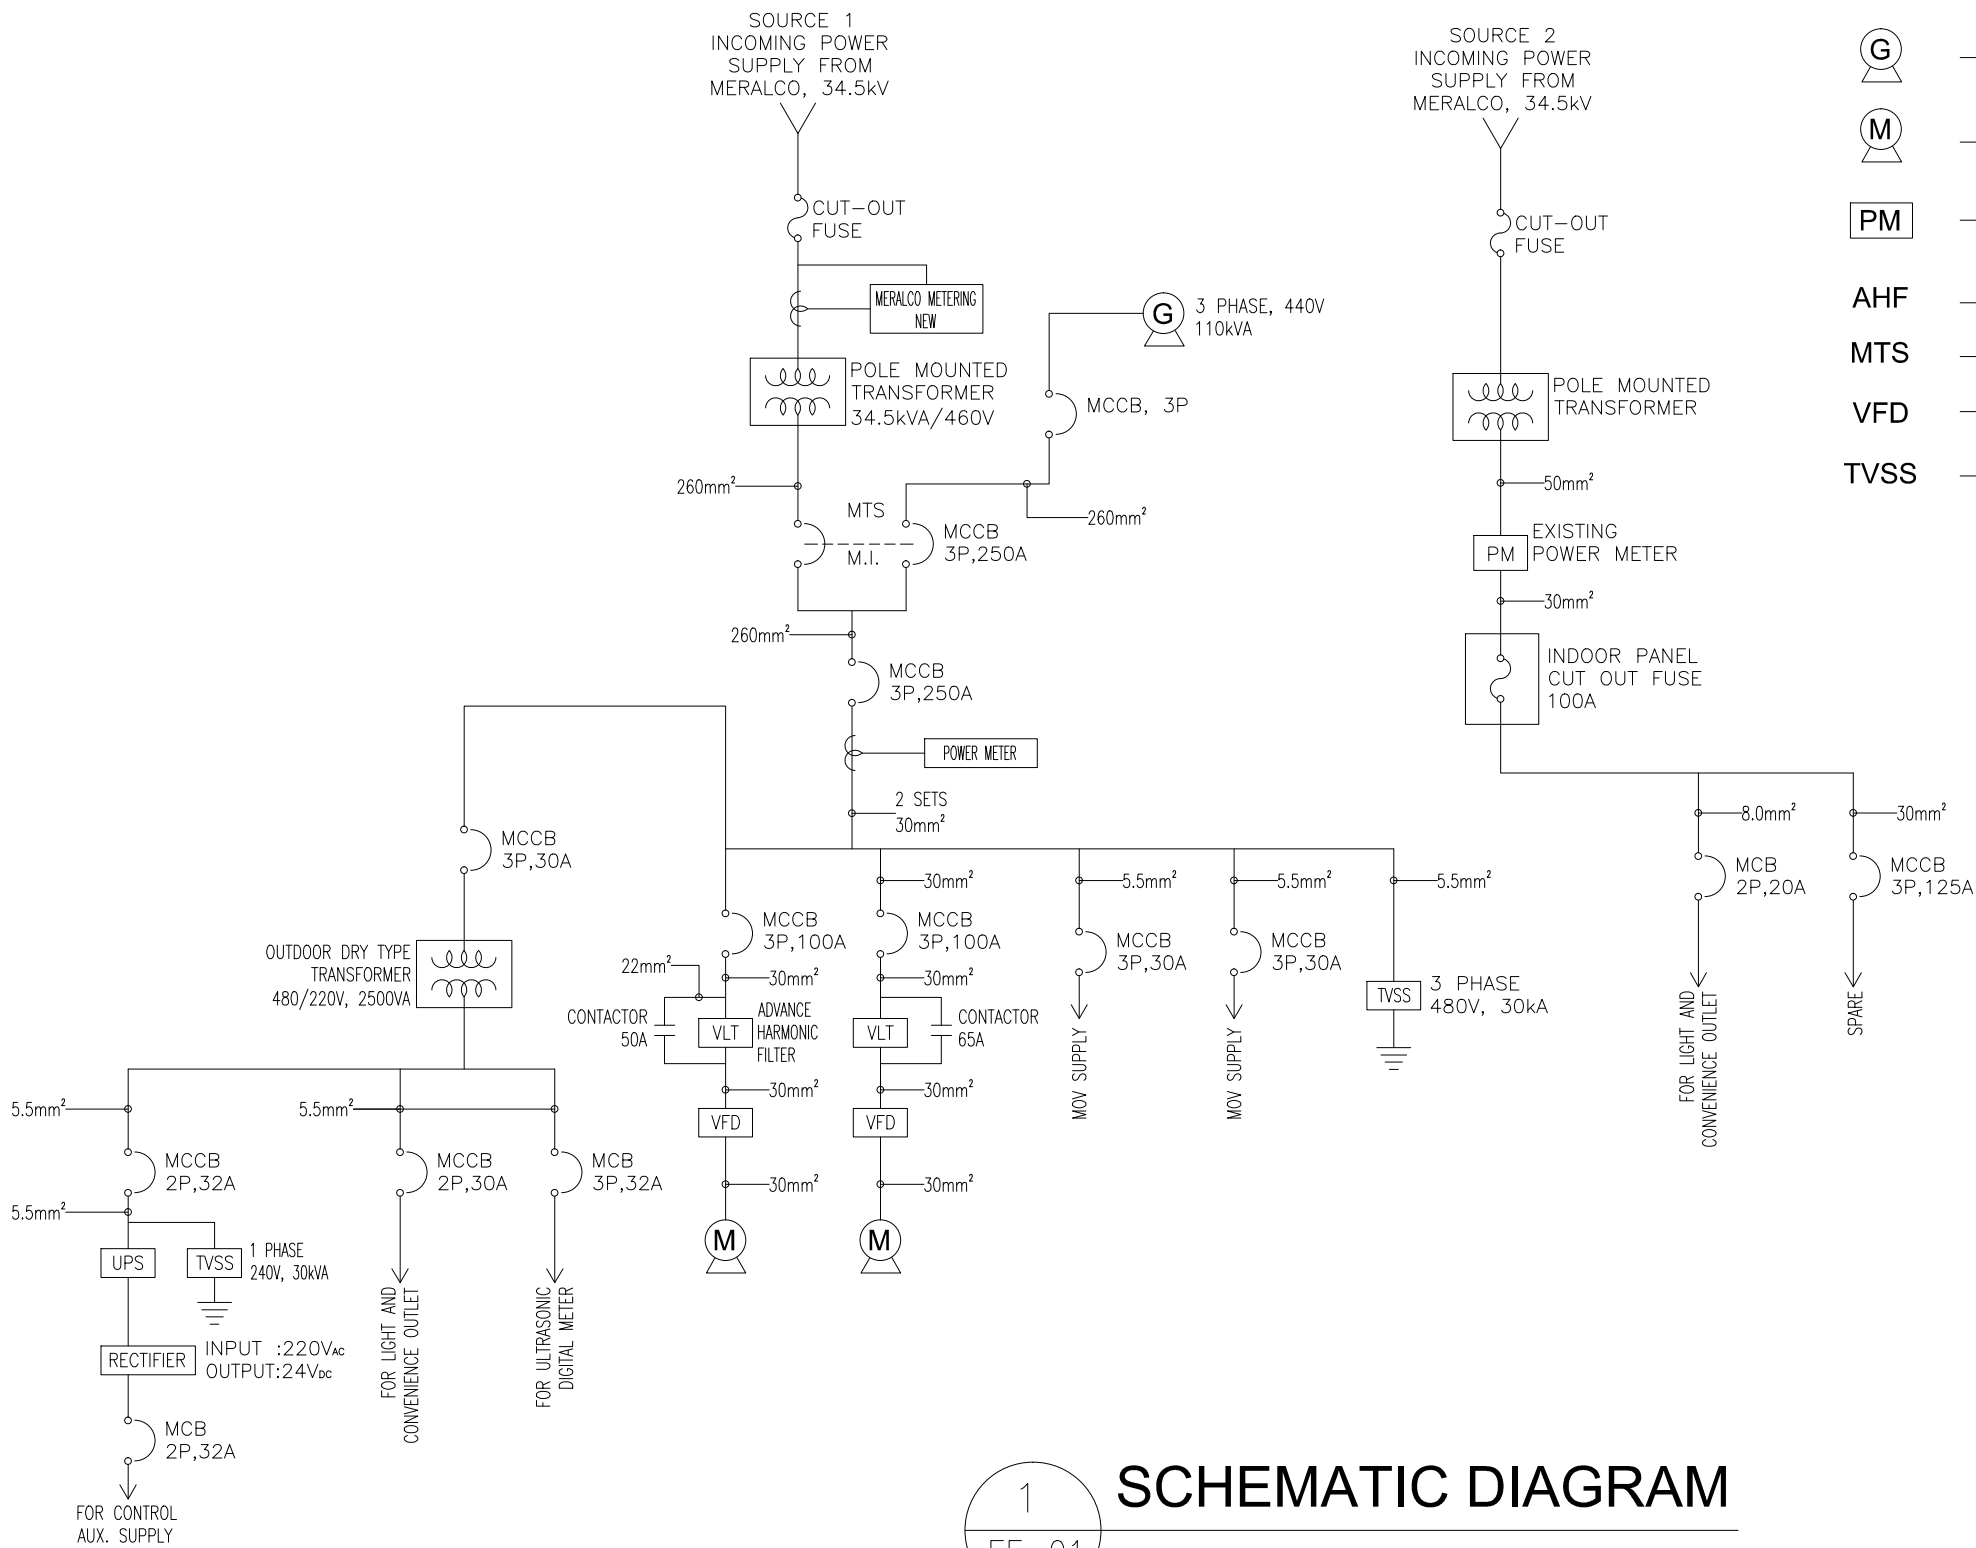

<div><div></div><div>Maynilad</div></div>		<div><div></div><div>Maynilad</div></div>	
CONFORME:		CONFORME:	
_____ HEAD, Division (End User)		_____ HEAD, Department (End User)	
DRAWN	SURVEYED	DESIGNED	CHECKED
REVISION			
REV	DATE	BY	APPROVED BY

Checked & Certified :	
ENGR. MARITES R. PANGILINAN Professional Electrical Engineer	
PROFESSION :	PTR :
REGISTRATION NO. :	DATE ISSUED :
TIN :	PLACE ISSUED :

<div><div></div><div>GHD</div></div>	11/F Alphaland Southgate Tower 2258 Chino Roces Ave corner EDSA Makati City 1232 Philippines T 63 2 479 5600 F 63 2 479 5601 E <a href="mailto:mnlmail@ghd.com">mnlmail@ghd.com</a> W <a href="http://www.ghd.com">www.ghd.com</a>
	Approved : _____ Project Manager

<div><div></div><div>ALTERNATIVE POWER SOLUTIONS, INC.</div></div>	DESIGN UNIT
	ENGR. MARITES R. PANGILINAN VP—OPERATIONS
DESIGN SECTION	

AS-BUILT DRAWING			
PROJECT TITLE: CONSULTANCY SERVICES FOR THE ENGINEERING, PROCUREMENT AND CONSTRUCTION MANAGEMENT FOR THE LA MESA TREATMENT PLANT 2 PROCESS IMPROVEMENT WORKS			
LOCATION: MAYNILAD — CHERRY IN LINE			
SHEET CONTENT: SCHEMATIC DIAGRAM			
SCALE:	CONTRACT NO. OP18REFCS03—CHE—EE01—SD	SHEET NO. 01 OF 01	REV. 00