




A FRONT ELEVATION PLAN  
ME SCALE 1:100

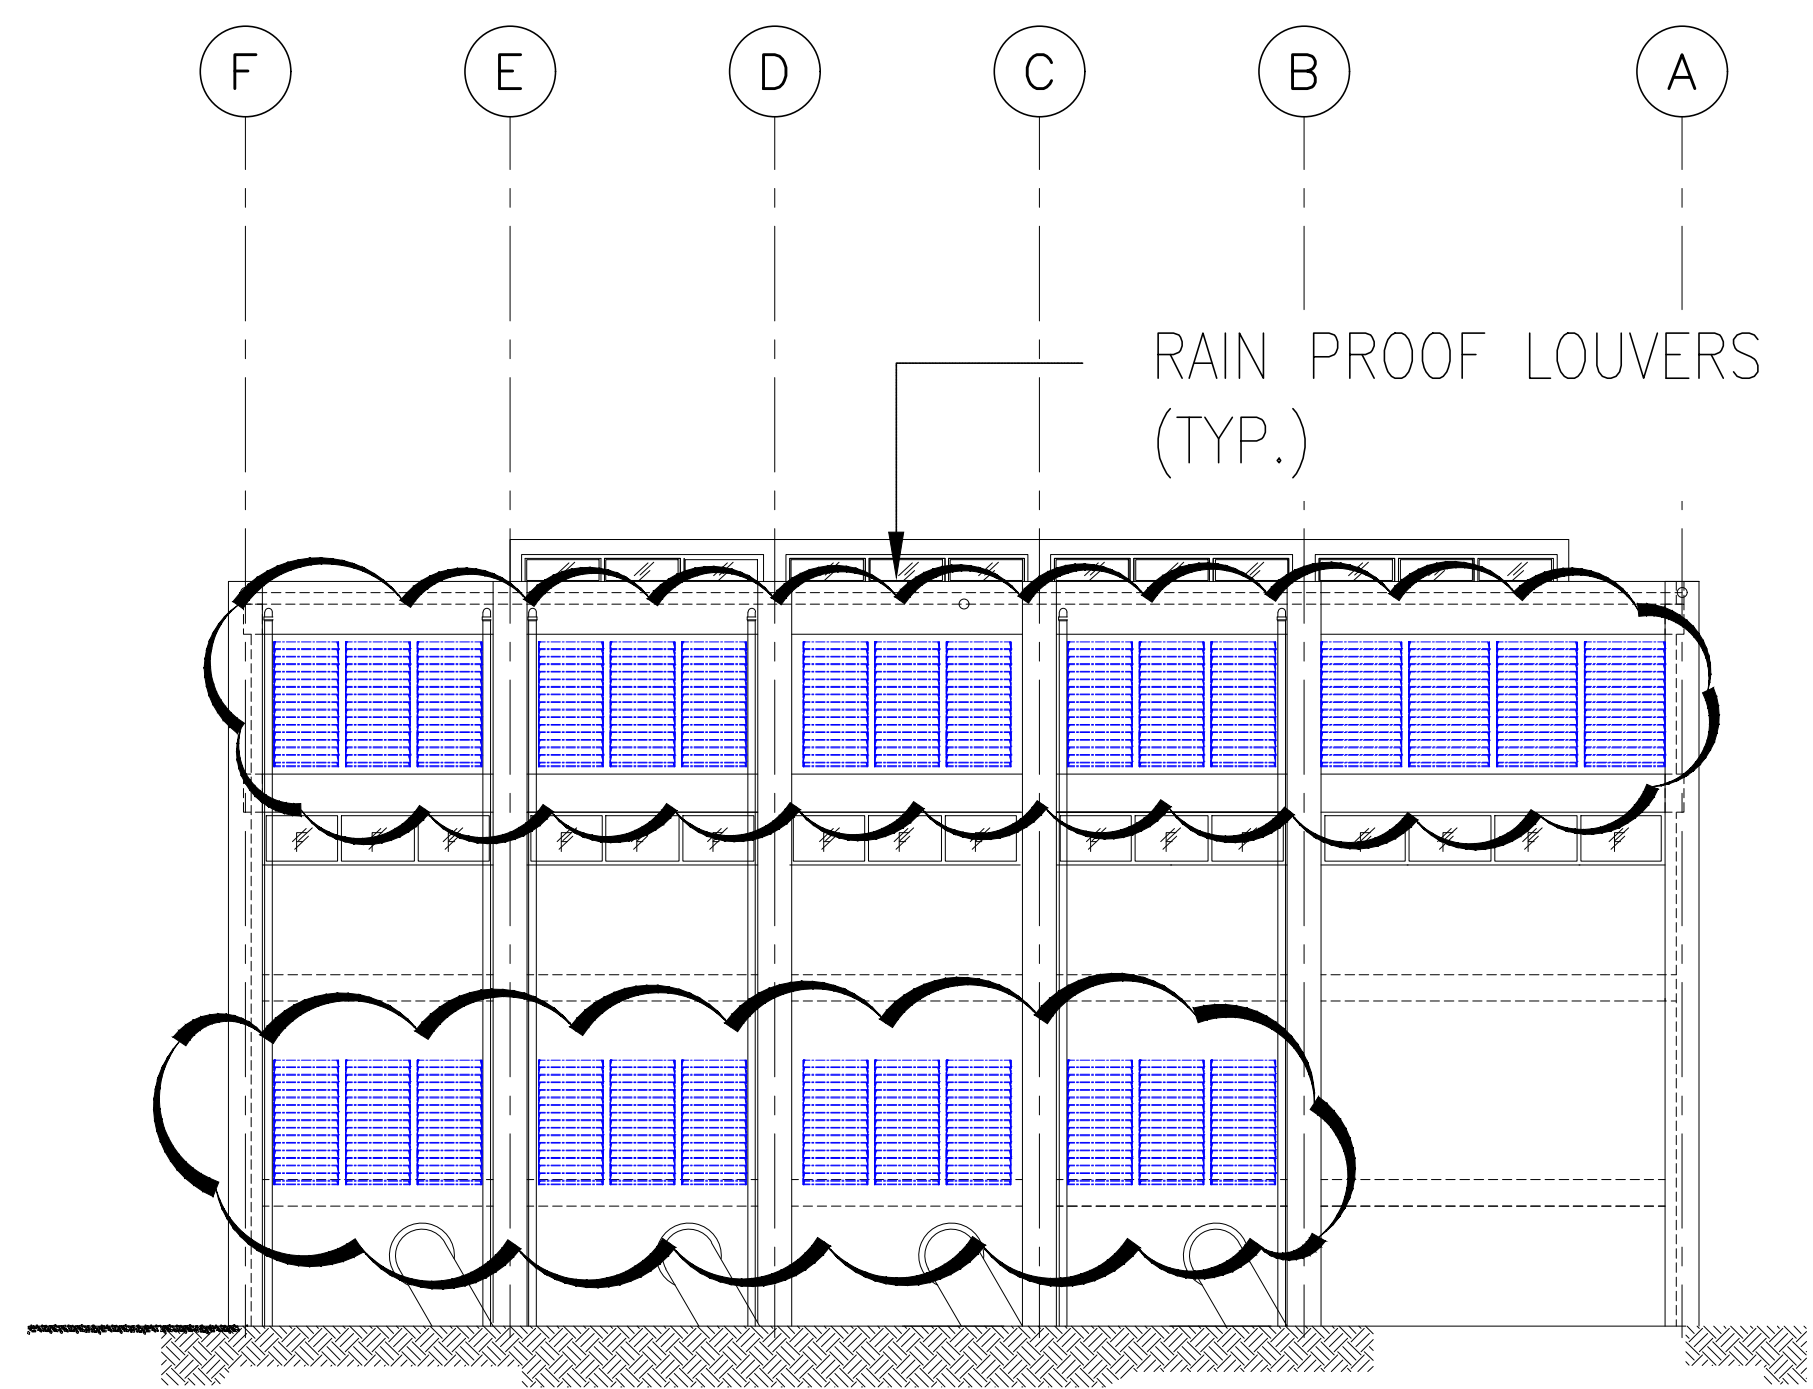


A REAR ELEVATION PLAN  
ME SCALE 1:100

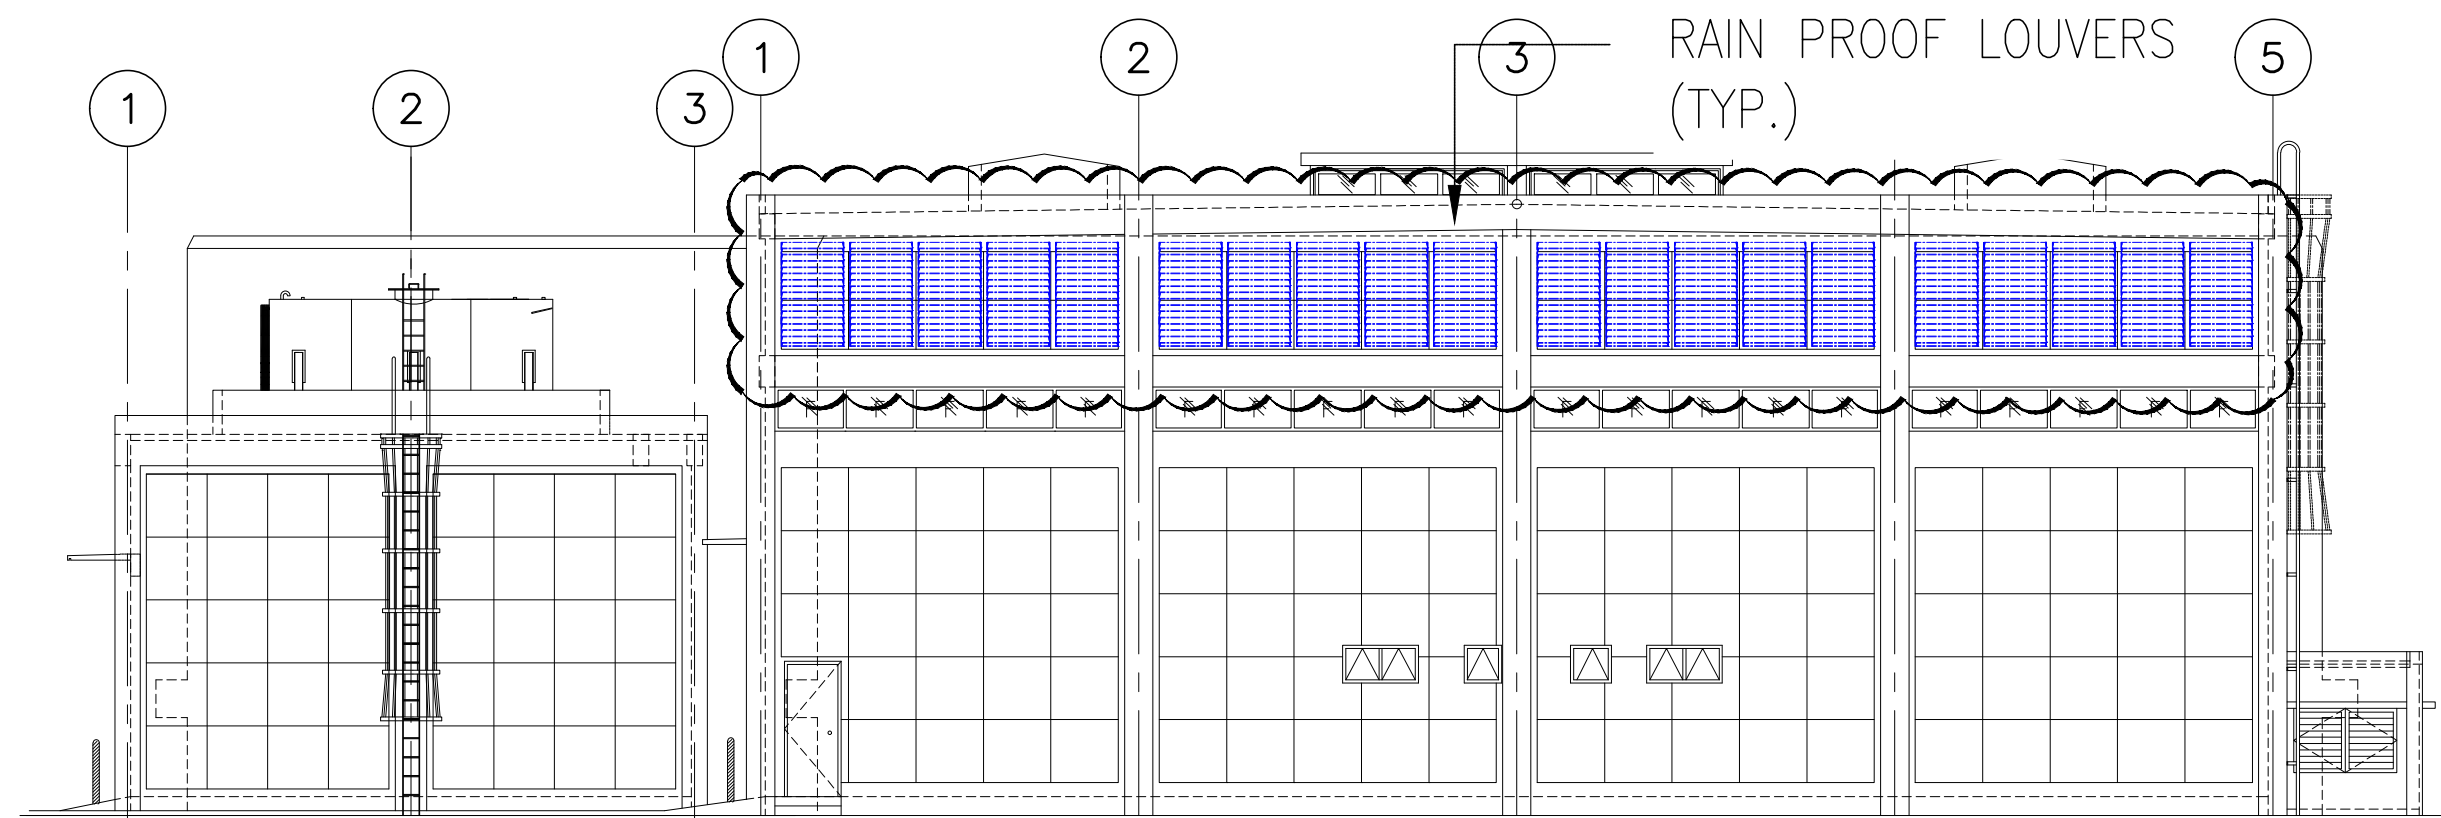

A RIGHT ELEVATION PLAN  
ME SCALE 1:120

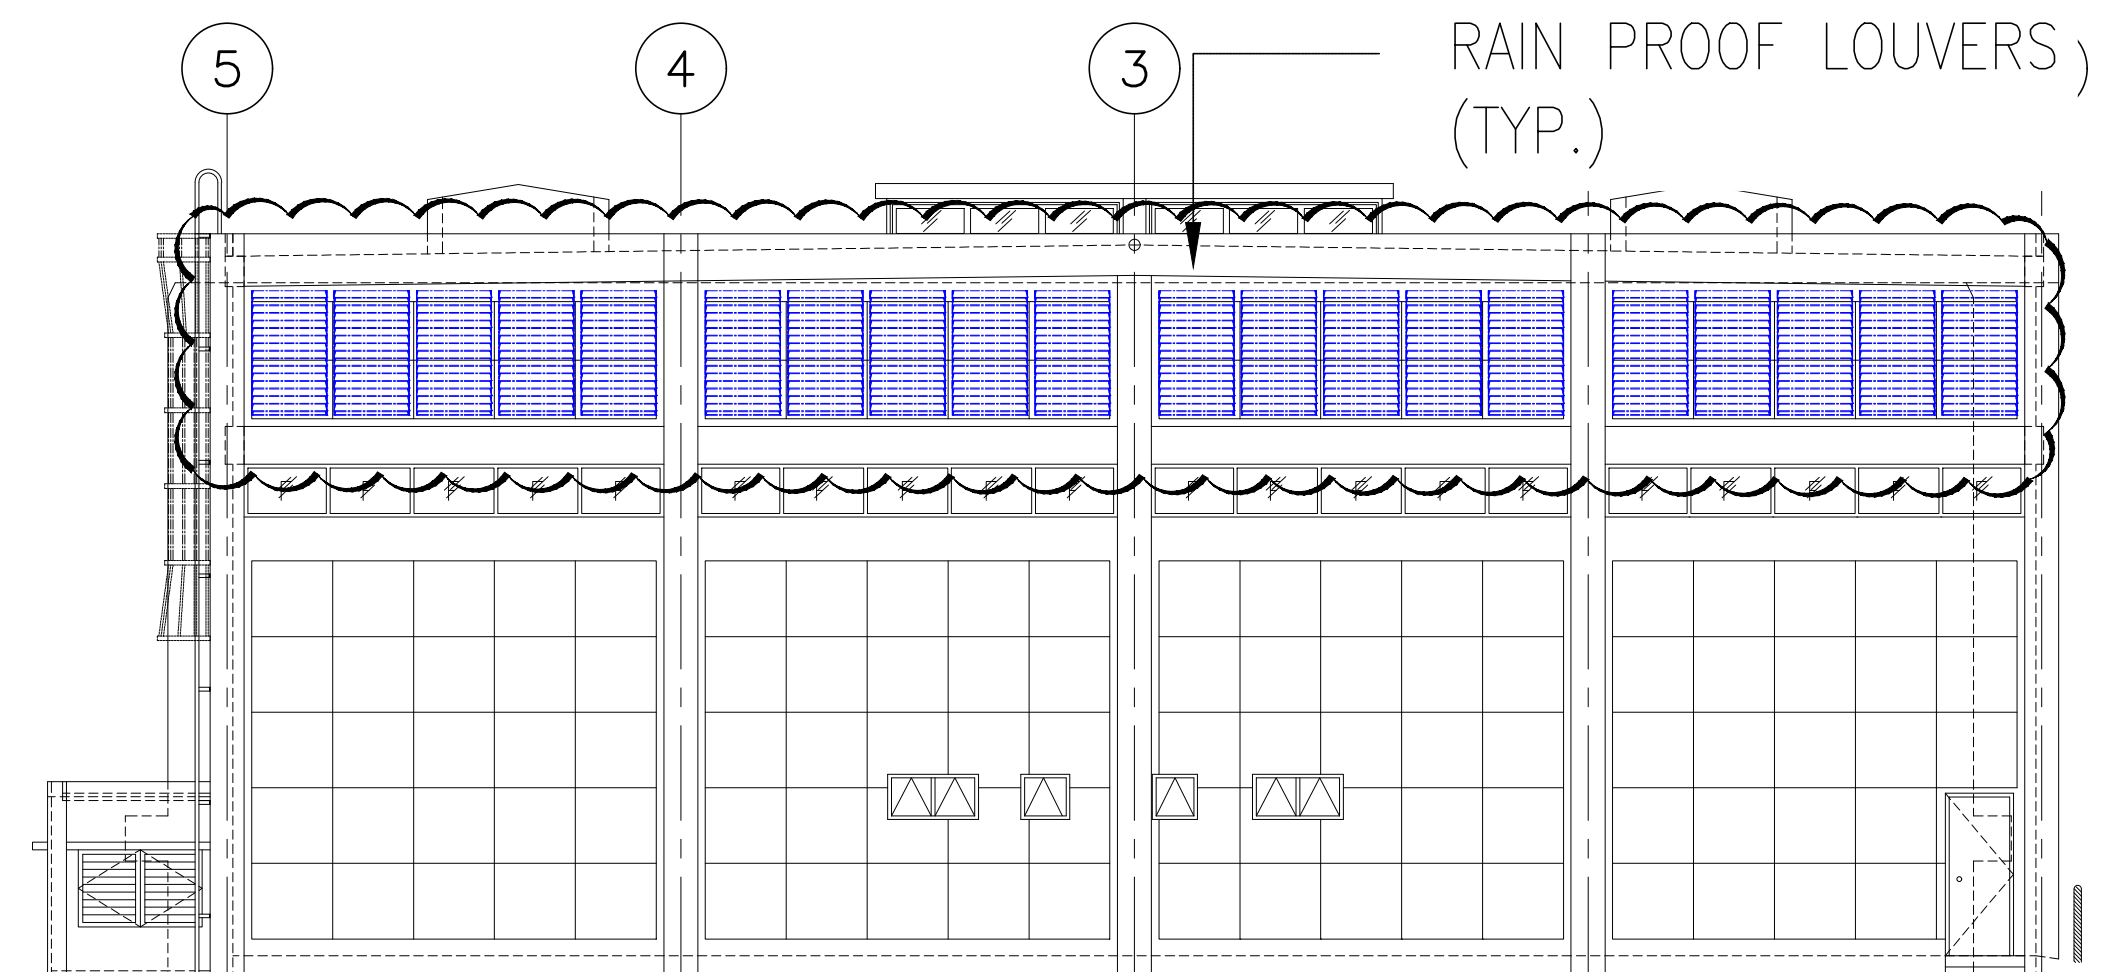

A LEFT ELEVATION PLAN  
ME SCALE 1:100

 CONFORME: _____ HEAD, Division (End User)		 CONFORME: _____ HEAD, Department (End User)		<p>1 NATURAL VENTILATION LAYOUT ME SCALE 1:100</p>				<p>NOTES: 1. THIS DRAWING IS CREATED IN REFERENCE TO AS-BUILT MECHANICAL DRAWING NO. OP-09-PPS-01, PASAY_ME-03. 2. REVISION CLOUD AND HIGHLIGHT INFORMATION WERE VERIFIED ON SITE THRU SITE VISUAL INSPECTION. OTHER INFORMATION WERE DIRECT COPY FROM THE AS-BUILT DRAWINGS PROVIDED BY MAYNILAD.</p>			
DRAWN	SURVEYED	DESIGNED	CHECKED								
DRAW	SURVEYED	DESIGNED	CHECKED	Checked & Certified : ROSENDO B. SANCHEZ, PME PROFESSIONAL MECHANICAL ENGINEER				<b>CONTRACT DRAWING</b>			
REVISION				PROFESSION : PME PTR : 7341148				PROJECT TITLE: CONSULTANCY SERVICES FOR THE PLANT AUDIT IN VARIOUS PUMP STATIONS AND RESERVOIRS			
				REGISTRATION NO. : 3999 DATE ISSUED : 01-07-2019				LOCATION: VILLAMOR PUMP STATION AND RESERVOIR			
REV	DATE	BY	APPROVED BY	TIN : 205-811-966 PLACE ISSUED : MAKATI_CITY				SHEET CONTENT: NATURAL VENTILATION LAYOUT			
								SCALE: NTS CONTRACT NO. OP18REFC503-VL-MECH-006 SHEET NO. 1 OF 1 REV. A			
				Approved : NAM LE Project Manager				RBS DESIGN UNIT ROSENDO B. SANCHEZ, PME HEAD, Engineering			
				11/F Alphaland Southgate Tower 2258 Chino Roces Ave corner EDSA Makati City 1232 Philippines T 63 2 479 5600 F 63 2 479 5601 E mnlmail@ghd.com W www.ghd.com				RBSANQUEZ PME CONSULTANTS & ASSOCIATES, INC. Makati Corporate Office: 28th Floor Cityland Pasong Tamo Tower U2807, 2210 Chino Roces Avenue, Makati City, Philippines Telefax No. 776-5879 Cell No. +639 273 006 000 Website: www.rbs-engineers.com			